

AMENDMENT OF SOLICITATION/MODIFICATION OF CONTRACT		1. CONTRACT ID CODE		PAGE OF PAGES 1 10	
2. AMENDMENT/MODIFICATION NO. DACA01-02-R-0011-0002		3. EFFECTIVE DATE 30 NOV 01		4. REQUISITION/PURCHASE REQ.	
5. PROJECT NO. (If applicable) M000F284		6. ISSUED BY CODE		7. ADMINISTERED BY (If other than item 6) CODE	
Corps of Engineers 109 st. Joseph St. Mobile, AL 36602				8. NAME AND ADDRESS OF CONTRACTOR (No., street, county, State and ZIP code)	
				<input checked="checked" type="checkbox"/> 9A. AMENDMENT OF SOLICITATION NO. DACA01-02-R-0011	
				9B. DATED (SEE ITEM 11) 30 OCT 2001	
				<input type="checkbox"/> 10A. MODIFICATION OF CONTRACT/ORDER NO. 10B. DATED (SEE ITEM 13)	
CODE		FACILITY CODE			
11. THIS ITEM ONLY APPLIES TO AMENDMENTS OF SOLICITATIONS					
<input checked="checked" type="checkbox"/> The above numbered solicitation is amended as set forth in item 14. The hour and date specified for receipt of Offers <input type="checkbox"/> is extended, <input checked="checked" type="checkbox"/> is not extended. Offers must acknowledge receipt of this amendment prior to the hour and date specified in the solicitation or as amended, by one of the following methods: (a) By completing items 8 and 15, and returning copies of the amendment; (b) By acknowledging receipt of this amendment on each copy of the offer submitted; or (c) By separate letter or telegram which includes a reference to the solicitation and amendment numbers. FAILURE OF YOUR ACKNOWLEDGEMENT TO BE RECEIVED AT THE PLACE DESIGNATED FOR THE RECEIPT OF OFFERS PRIOR TO THE HOUR AND DATE SPECIFIED MAY RESULT IN REJECTION OF YOUR OFFER. If by virtue of this amendment you desire to change an offer already submitted, such change may be made by telegram or letter, provided each telegram or letter makes reference to the solicitation and this amendment, and is received prior to the opening hour and date specified. letter, provided each telegram or letter makes reference to the solicitation and this amendment, and is received prior to the pening hour and date specified.					
12. ACCOUNTING AND APPROPRIATION DATA (if required)					
13. THIS ITEM APPLIES ONLY TO MODIFICATIONS OF CONTRACTS/ORDERS, IT MODIFIES THE CONTRACT/ORDER NO. AS DESCRIBED IN ITEM 14.					
<input type="checkbox"/>	A. THIS CHANGE ORDER IS ISSUED PURSUANT TO: (Specify authority) THE CHANGES SET FORTH IN ITEM 14 ARE MADE IN THE CONTRACT ORDER NO. IN ITEM 10A ITEM 10A				
<input type="checkbox"/>	B. THE ABOVE NUMBERED CONTRACT/ORDER IS MODIFIED TO REFLECT ADMINISTRATIVE CHANGES (such as changes in paying office, appropriation date, etc.) SET FORTH IN ITEM 14, PURSUANT TO AUTHORITY OF FAR 43.103(b)				
<input type="checkbox"/>	C. THIS SUPPLEMENTAL AGREEMENT IS ENTERED INTO PURSUANT TO AUTHORITY OF:				
<input type="checkbox"/>	D. OTHER (Specify type of modification and authority)				
E. IMPORTANT: Contractor <input type="checkbox"/> is not <input type="checkbox"/> is required to sign this document and return copies to the issuing office					
14. DESCRIPTION OF AMENDMENT/MODIFICATION (Organized by UCF section headings, including solicitation/contract subject matter where feasible)					
The subject solicitation ADAL SQUADRON OFFICERS COLLEGE, MAXWELL AFB, AL.					
Is modified in the following: - REFER TO THE ENCLOSED REVISED DRAWINGS AND SPECIFICATION PAGES FOR AMENDMENT NO. 2 -					
NOTE: THE PROPOSAL RECEIPT DATE WAS EXTENDED TO 11 DECEMBER 2001 BY AMENDMENT NO. 1. AMENDMENT NO. 1 WITH ADDITIONAL TECHNICAL REVISIONS WILL BE ISSUED ON CD-ROM (COMPACT DISC) TO ALL REGISTERED PLAN HOLDERS VIA U.S. POSTAL MAIL ON 30 NOV 2001.					
15A. NAME AND TITLE OF SIGNER (Type or print)			16A. NAME AND TITLE OF CONTRACTING OFFICE (Type or print)		
15B. CONTRACTOR/OFFEROR		15C. DATE SIGNED		16B. UNITED STATES OF AMERICA BY	
(Signature of person authorized to sign)				(Signature of contracting officer)	
16C. DATE SIGNED					

NSN 7540-01-152-8070
 PREVIOUS EDITION UNUSABLE

30-105

STANDARD FORM 30 (REV. 10-83)
 Prescribed by GSA

PART I - REVISIONS MADE BY ADDED AND/OR REPLACEMENT PAGES, SECTIONS OR
PARAGRAPHS

The revisions listed below are to be replaced by the corresponding added and/or revised pages/sections/paragraphs. Paragraphs added and/or revised in sections are to be replaced without regard to page number changes caused by the revision.

Within the specifications, deletions from the specifications are indicated by: strikethrough, e.g.: ~~deletions are marked with strikethrough~~; and additions to the specifications, including revisions/substitutions, are indicated in bold, italic and underlined, e.g.: ***additions are indicated thus.*** Added and/or revised paragraphs/pages/sections are indicated by a note in bottom right hand corner of each page, and are hereby made a part of the contract and are to be inserted in the specification in the proper numerical-alphabetical sequence.

<u>Page/Paragraphs</u>	<u>Corresponding Added or Revised Pages and/or Paragraphs</u>
SECTION 05500A	REVISED PARAGRAPH 2.28 .
SECTION 08710	REVISED PAGES 10, 11, AND 12.

NOTE: Revised drawings are listed below. These revised drawings are to be inserted into the folio in the proper numerical sequence. Drawings which have been revised or replaced by this amendment shall be deleted from the folio.

<u>File</u>	<u>Sheet</u>	<u>Reference</u>	<u>Latest</u>	<u>Title</u>
<u>Number</u>	<u>Number</u>	<u>Date</u>		
284A510F.DWG	MAX-74-87	A-510		Toilet Details
284A602F.DWG	MAX-74-91	A-602		Door Schedule
284A603F.DWG	MAX-74-92	A-603		Wall Types

Encl

Revised pages, paragraphs of the specifications as indicated in Part I.
3 Revised drawings as indicated in NOTE above.

ADAL SQUADRON OFFICERS COLLEGE, MAXWELL AFB, AL
M000F284 DACA01-02-R-0011 AMENDMENT 0002

Replace paragraph 2.28 of SECTION 05500A with the following:

2.28 FIRE EXTINGUISHER CABINETS

2.28.1 Recessed Fire Extinguisher Cabinets

Sample models listed below indicate style. Refer to Section 09915 for finishes which vary for specific locations.

a. Manufacturer and type: Potter-Roehmer, Inc., '7000 LOMA Series, 7367 BA, fire extinguisher cabinet.

- (1) Cabinet: 22 gauge steel box.
- (2) Trim: Flat , 16 mm wide face, stainless steel.
- (3) Door: "Suffix BA Door style "Full Bubble" with catch, 304 stainless steel door with 4 finish, with glass smoke tinted.
- (4) Hinge: 180 degree opening with continuous piano hinge.
- (5) Pull and Latch: Roller catch and manufacturer's standard pull handle.

b. Other Acceptable Manufacturers:

- (1) J.L. Industries.
- (2) Larsen's Manufacturing Company. Text

CONTINUATION

* HW-3 Doors 113 114 143
2 ea. Flush Bolts, L024081
1 ea. Threshold, equal to 896 BR (NG)
1 ea. Astragal, equal to 146NDkB (NG)
1 ea. Rain Drip
1 ea. Weatherstripping, equal to 700NDkB (NG)

HW-4 Doors 120

4 pr. Hinges, A8112
1 ea. Lockset, F08, Grade 1
1 ea. Mortise Dead Lock, E16062
2 ea. Overhead Holders, C09521
2 ea. Flush Bolts, L024081
1 ea. Dust proof strike, L04021
2 ea. Kickplate, J102

HW-5 Doors 134 121

3 pr. Hinges, A8112
1 ea. Lockset, F08, Grade 1
2 ea. Overhead Holders, C09521
2 ea. Flush Bolts, L024081
1 ea. Coordinator
1 ea. Dust proof strike, L04021
2 ea. Kickplate, J102
2 ea. Silencers, L03011

HW-6 Doors 111 112

3 pr. Hinges, A2112
2 ea. Closers, C02011
1 ea. Lockset, F07, Grade 1
2 ea. Overhead Holders, C02511
2 ea. Exit Device, Type 1, Function 08
1 ea. Removable Mullion, Type 22
1 ea. Threshold, equal to 896 BR (NG)
2 ea. Kickplates, J102
1 ea. Rain Drip
1 ea. Weatherstripping, equal to 700NDkB (NG)

HW-7 Doors 117 118 234 235 247 248 158 160

1 1/2 pr. Hinges, A8133
1 ea. Lockset, F07
1 ea. Floor Stop, L02141
1 ea. Kickplate, J102
3 ea. Silencers, L03011

HW-7 Doors 117 118 234 235 247 248 158 160

HW-8 Doors 142

1 1/2 pr. Hinges, A2111
1 ea. Lockset, F07
2 ea. Overhead Holders, C02511
1 ea. Threshold, J601
1 ea. Raindrip
1 ea. Weatherstripping,

* HW-9 Doors ¹²²~~112~~ 123 157 159 216 217 251 252

1 1/2 pr. Hinges, A2133
1 ea. Closer, C02021
1 ea. Overhead Holder, C02511
1 ea. Push Plate, J304, 75mm x 300mm
1 ea. Door Pull, J401
1 ea. Kickplate, J102
1 ea. Mop Plate, J100
3 ea. Silencers, L03011

HW-10 Doors 131 133

1 1/2 pr. Hinges, A8133
1 ea. Closer, C02021
1 ea. Overhead Holder, C02511
1 ea. Push Plate, J304, 75mm x 300mm
1 ea. Door Pull, J406 Brass
1 ea. Kickplate, J102
3 ea. Silencers, L03011

HW-11 Doors 146-156, 219 221-224, 227-233, 116, 130

1 1/2 pr. Hinges, A8133
1 ea. Lockset, F05
1 ea. Holder C02511
1 ea. Kickplate, J102
3 ea. Silencers, L03011

HW-12 Doors 265 266 267 140 145 173 177 183 201 212 225

1 1/2 pr. Hinges, A8133
1 ea. Closer, C02011
1 ea. Exit Device, Type 1, Function 08

continuation

* HW-12 Doors 265 266 267 140 145 173 177 183 201 212 225
1 ea. Floor Stop, L02141
1 ea. Kickplate, J102
3 ea. Silencers, L03011

* HW-13 Doors 127 129 161 164 167 169 171 172 204 207 208, 211, 213, 214, 244
239 246 256 259 262 264

1 1/2 pr. Hinges, A8133
1 ea. Lockset, F04
1 ea. Holder C02511
1 ea. Kickplate, J102
3 ea. Silencers, L03011

HW-14 Doors 119 125 128 132 162 163 165 166 168 174 202
203 205 206 209 215 237 238 241 242 243 245
249 253 254 255 257 261 ~~268~~ 269, 236

*

1 1/2 pr. Hinges, A8133
1 ea. Lockset, F04
1 ea. Floor Stop, L02141
1 ea. Kickplate, J102
3 ea. Silencers, L03011


268

HW-15 Doors 218 258

1 1/2 pr. Hinges, A8133
1 ea. Lockset, F07
1 ea. Floor Stop, L02141
1 ea. Automatic Door Bottom equal to 367A (Zero)
3 Sides Sound Gasketing equal to 3708A (Zero)
1 ea. Threshold similar or equal to 168A (PK)
3 ea. Silencers, L03011

HW-16 Doors 124

1 1/2 pr. Hinges, A8133
1 ea. Closer, C02021
1 ea. Lockset, F07
1 ea. Floor Stop, L02141
1 ea. Automatic Door Bottom equal to 367A (Zero)
3 Sides Sound Gasketing equal to 3708A (Zero)
1 ea. Threshold similar or equal to 168A (PK)
3 ea. Silencers, L03011

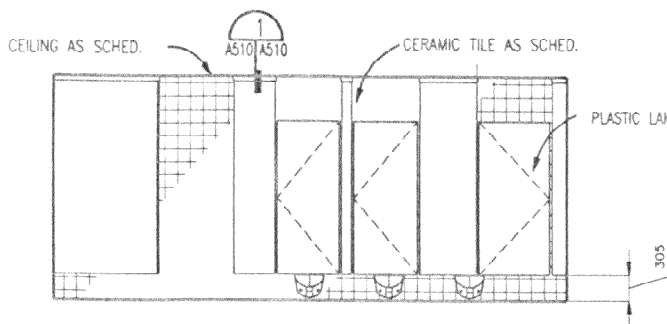


ELEVATION RM. 112 & 143

ELEVATION RM. 214 & 245

SCALE: 1:40

A509 A510

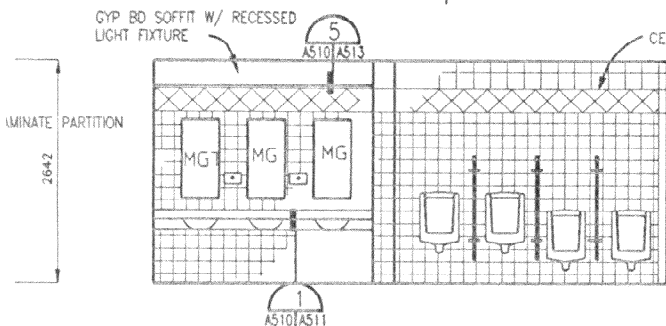

ELEVATION RM. 111 & 142


ELEVATION RM. 213 & 244

SCALE: 1:40


HC STALL (TYP)

SCALE: 1:40

A509 A510

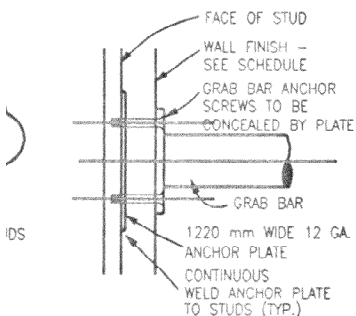

TYP. GRAB BAR MOUNTING @ WALL

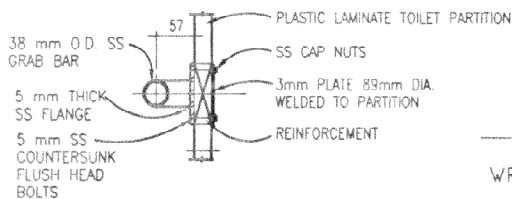



TYP. GRAB BAR MTG. @ TOIL. PART.

LEGEND

- WR WASTE RECEPTACLE
- MG MIRROR GLAZED
- MGT MIRROR GLAZED TILT (HC)
- TTD TOILET TISSUE DISPENSER
- CH COAT HOOK
- GB GRAB BAR
- SD SOAP DISPENSER
- SND SANITARY NAPKIN DISPOSAL

RAGE DETAIL

TYP. A510

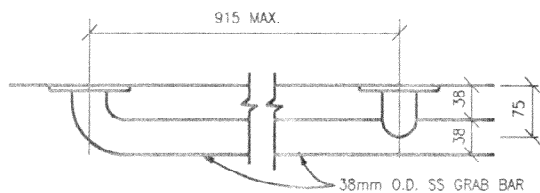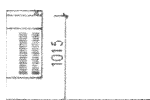

TYPICAL GRAB BAR RETURN DETAIL

SCALE: 1:5

TYP. A510





Revisions	Description	Date	By	Appr.
1		11/22/90	JBK	
2				
3				
4				
5				
6				

Date:	OCTOBER 2001
File No.:	MAX-74-87
U.S.C. Spec. File Name:	284A510F.DWG
Solicitation Number:	DAC401-02-R-0011
Designed By:	J.M. CHLOS
Drawn By:	J.M. CHLOS
Checked By:	C.V. KING
Reviewed By:	B.R. THOMAS

MAXWELL AFB, ALABAMA ADAL SQUADRON OFFICER COLLEGE TOILET DETAILS

Sheet Reference Number: A-510
--

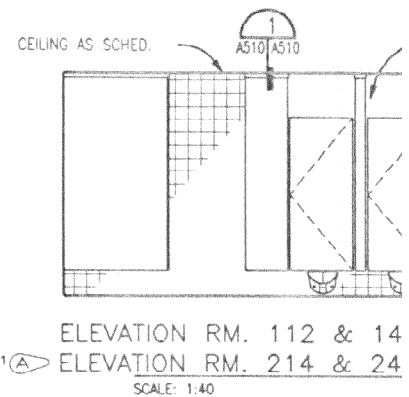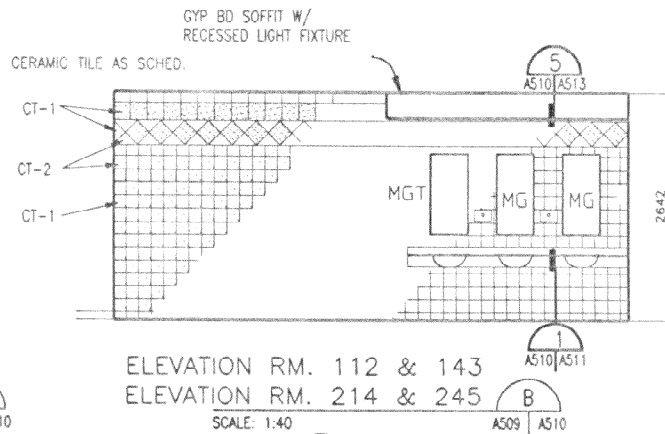

ELEVATION RM. 112 & 143
ELEVATION RM. 214 & 245




SCALE: 1:40

ELEVATION RM. 112 & 143
ELEVATION RM. 214 & 245

SCALE: 1:40

ELEVATION RM. 112 & 14
ELEVATION RM. 214 & 24

SCALE: 1:40

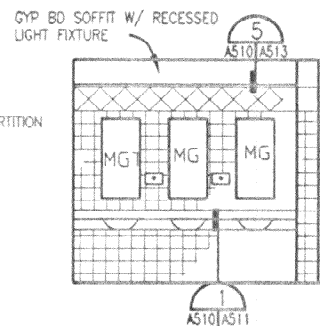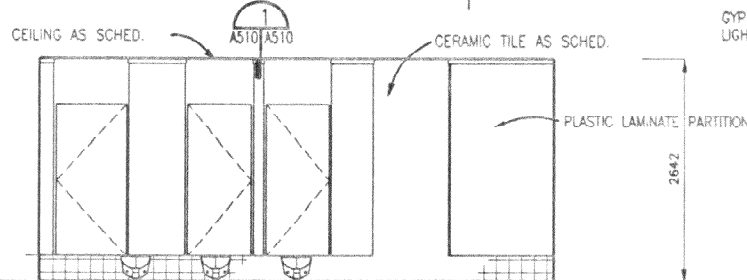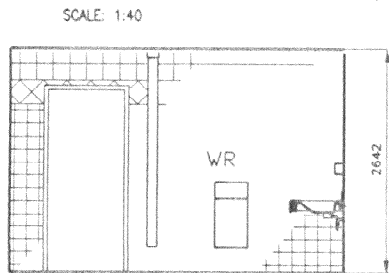

ELEVATION RM. 111 & 142
ELEVATION RM. 213 & 244


SCALE: 1:40

ELEVATION RM. 111 & 142
ELEVATION RM. 213 & 244



SCALE: 1:40

ELEVATION RM. 111 & 1
ELEVATION RM. 213 & 2

SCALE: 1:40

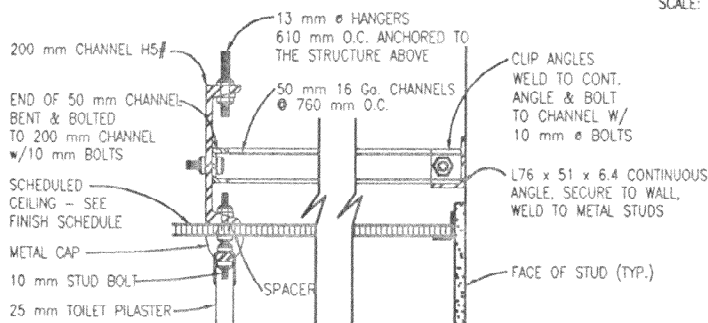

SCALE: 1:40

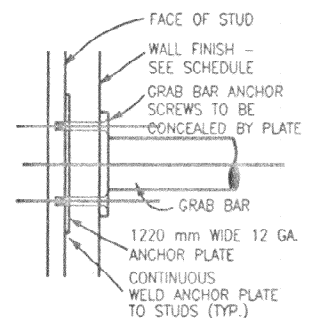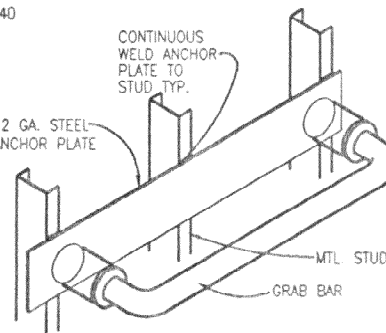

TYPICAL CEILING HUNG TOILET
PARTITION ANCHORAGE DETAIL


SCALE: 1:5

ISOMETRIC OF GRAB BAR ANCHOR PLATE

TYP. GRAB BAR MOUNTING @ WALL

TYPICAL GRAB BAR ANCHORAGE DETAIL

SCALE: N.T.S.

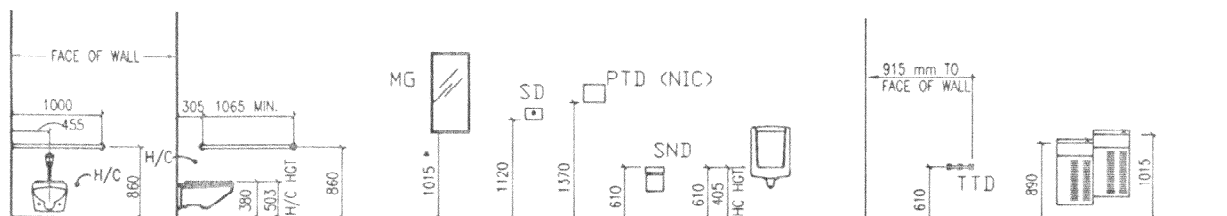

* DIMENSIONED TO BOTTOM EDGE OF
REFLECTIVE SURFACE

AMENDMENT 0002

SHEET
REF. No.
A-510




US Army Corps
of Engineers
Mobile District

Date: OCTOBER 2001
File No. MAX-74-91
I.S.O. Sheet File Name: 284A602F.DWG
Solicitation Number: DACA01-02-R-001





U.S. ARMY ENGINEER DISTRICT CORPS OF ENGINEERS MOBILE, ALABAMA	Designed By: J.M.CHILDS
	Drawn By: J.M.CHILDS
	Checked By: C.V.KLING
	Reviewed By: B.R.THOMAS

Sheet
Reference
Number:
A-602


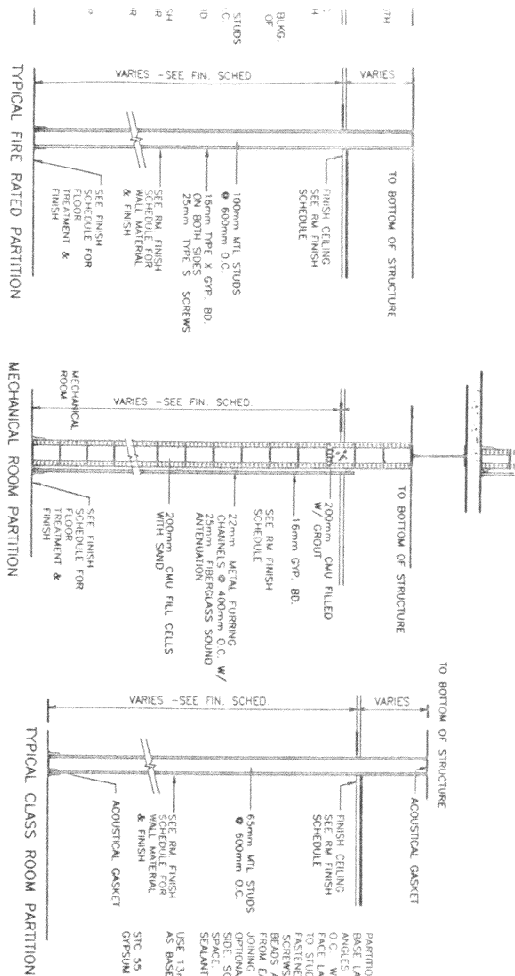


PARTITION TYPE 4
 PARTITION TYPE 4 IS 13mm GYP. BD. APPLIED AT ROOF ANGLES TO EXISTING 100mm TYPE X GYP. BD. WITH 20mm TYPE 3 SCREWS 300mm O.C. FACE LAYER 16mm TYPE X GYP. BD. APPLIED PARALLEL TO EXISTING 100mm TYPE X GYP. BD. WITH 20mm TYPE 3 SCREWS 300mm O.C. USE OF 10mm TO 13mm DIAL BEADS AROUND THE PERIMETER OF FACE BOARD. 30mm ADHESIVE BEADS TO BE APPLIED TO THE PERIMETER OF FACE BOARD. JOINTS OF THE PERIMETER BEADS TO BE JOINTED WITH 60mm GYP. BD. EACH LAYER AND SEALANT TAPE CONTINUOUS AROUND CHANNEL IN STUD

PARTITION TYPE 4
 PARTITION TYPE 4 IS 13mm GYP. BD. APPLIED AT ROOF ANGLES TO EXISTING 100mm TYPE X GYP. BD. WITH 20mm TYPE 3 SCREWS 300mm O.C. FACE LAYER 16mm TYPE X GYP. BD. APPLIED PARALLEL TO EXISTING 100mm TYPE X GYP. BD. WITH 20mm TYPE 3 SCREWS 300mm O.C. USE OF 10mm TO 13mm DIAL BEADS AROUND THE PERIMETER OF FACE BOARD. 30mm ADHESIVE BEADS TO BE APPLIED TO THE PERIMETER OF FACE BOARD. JOINTS OF THE PERIMETER BEADS TO BE JOINTED WITH 60mm GYP. BD. EACH LAYER AND SEALANT TAPE CONTINUOUS AROUND CHANNEL IN STUD

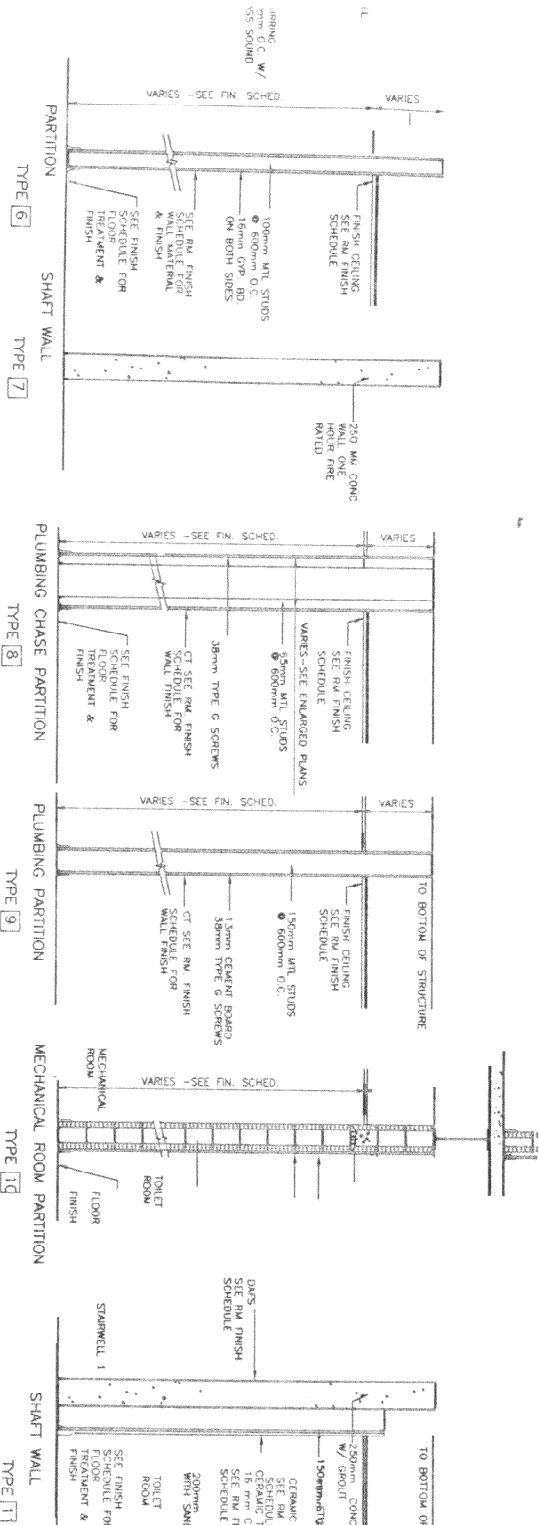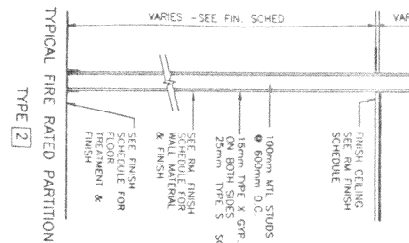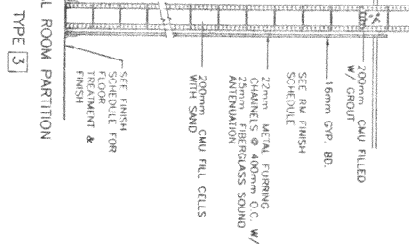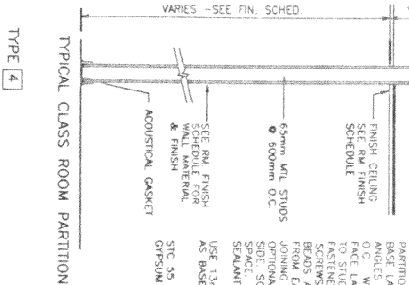

NOTE: USE 13mm GYP. BD. IN JEU OF GYPSUM FACE BOARD AS BASE FOR CERAMIC TILE FINISHES.

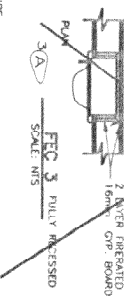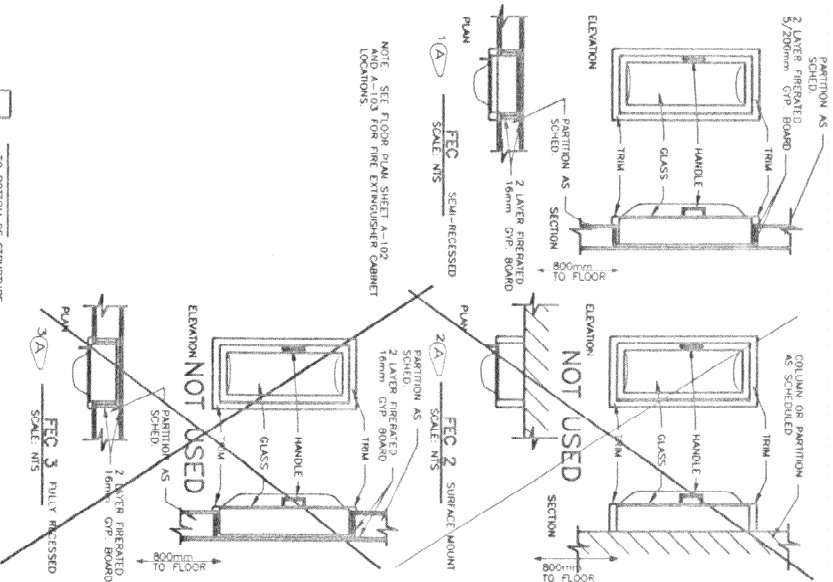

400 0 400mm
 SCALE: 1" = 20"

Sheet
 Number
 A-603

MAXWELL AFB, ALABAMA
 ADAL SQUADRON OFFICER COLLEGE
 WALL TYPES

U.S. ARMY ENGINEER DISTRICT
 CORPS OF ENGINEERS
 MOBILE, ALABAMA
 Designed By: J.M. CHILDS
 Drawn By: J.M. CHILDS
 Checked By: C. K. KUNG
 Reviewed By: B.R. THOMAS
 Date: OCTOBER 2001
 File No: MAX-74-92
 L&D Sheet File Name: 284A0303P.DWG
 Submittal Number: DCA01-02-R-0011

Symbol	No.	REVISION	Description	Date	By	Approved

U.S. Army Corps
 of Engineers
 Mobile District